

AMENDMENTS

NO.	DATE	DESCRIPTION	APPROVED
1	27.06.2017	SWITCHBOARD ADDED FOR ESLS075803 & 075804.	RH

NOTES

REFERENCES

DESCRIPTION	DRAWING No.
LEGEND (SYMBOLS)	8525-0316 & 8525-0317
FLASHING SCHOOL ZONE SIGNS	0648-1269
40KM/H PAVEMENT MARKINGS	200631-0022




METROPOLITAN REGION



WATERLOO CRESCENT EAST PERTH 6004
 Telephone (08) 9323 4111 Fax (08) 9323 4684

SURVEYED		DATE
DRAWN	P. BARUA	20.06.2017
CHECKED	E. POLLARD	21.06.2017
AUTHORISED	R. HARRIS	26.06.2017
RECOMMENDED		

IVY STREET (0019)
 BROOMEHILL PRIMARY SCHOOL
 AS CONSTRUCTED
 ELECTRONIC SPEED LIMIT SIGNS

LOCAL AUTHORITY (303) SHIRE OF BROOMEHILL-TAMBELLUP (BROOMEHILL)	COMMISSIONED	24.08.2016
DRAWING NUMBER	201601-0379	REV. 1

ESLS0758

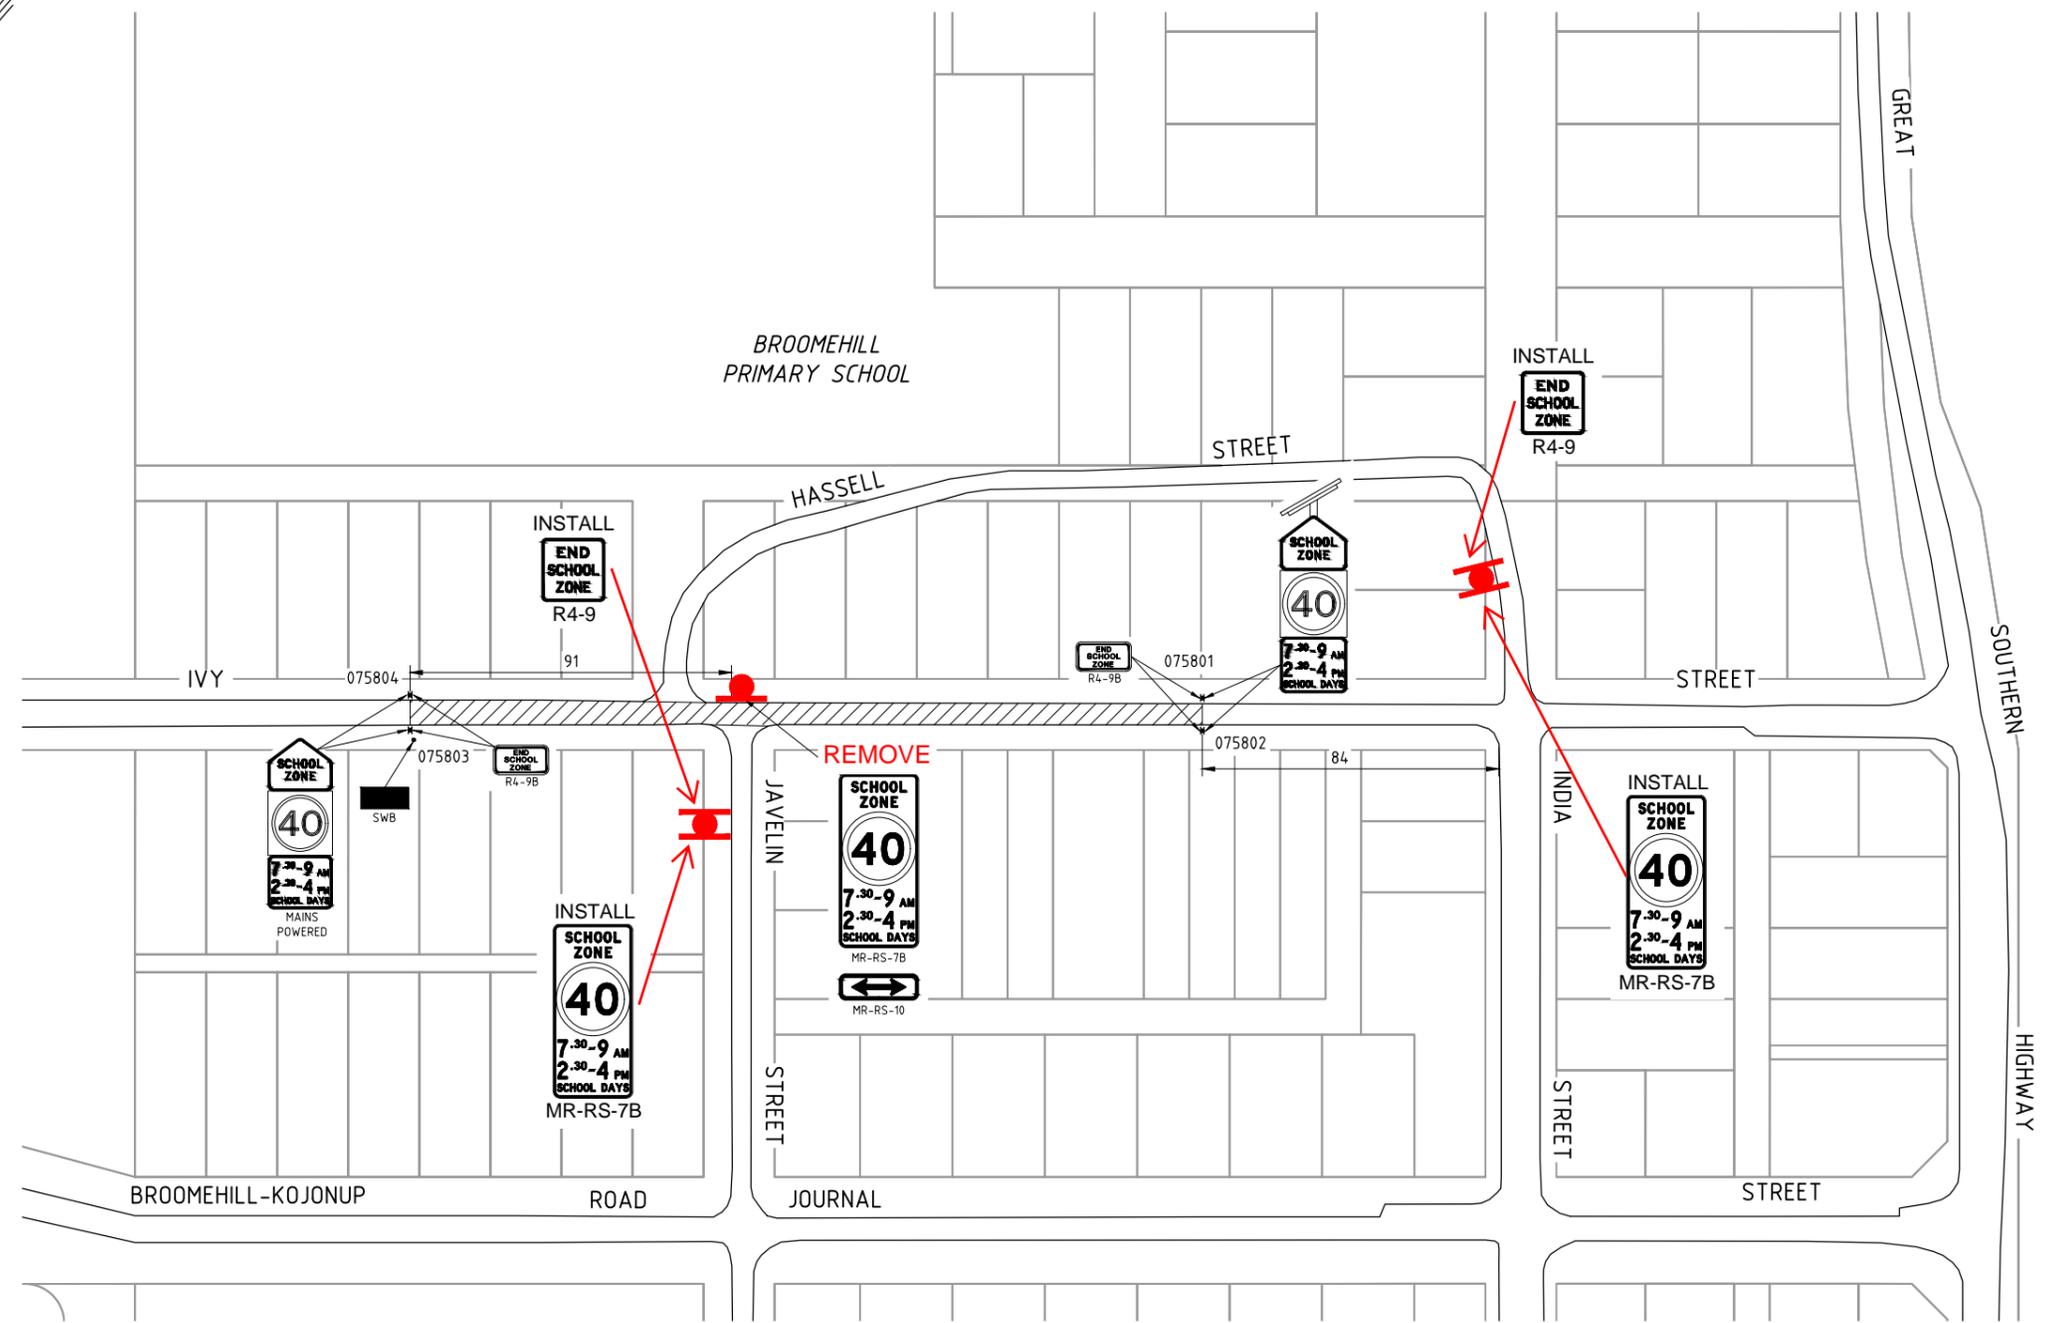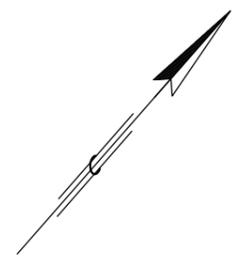

ESLS SCHEDULE					
POLE No.	CO-ORDINATES		GROUP No.	MANUFACTURER	MODEL
	LATITUDE	LONGITUDE			
075801	-33.84490	117.63674	ESLG0758-01	J1	JT-D-0081
075802	-33.84501	117.63684	ESLG0758-01		
075803	-33.84635	117.63502	ESLG0758-03		
075804	-33.84629	117.63495	ESLG0758-03		
SWB. 03 & 04	-33.84636	117.63505			

SCALE 1:1000
 METRE MARKING
 A1